

4/21/21 B.Y. BY: DESIGN DRAWN 2 2 10-7 6 SL PER MONTGOMERY 1
PER MONT. TWP. REV. L.O.D, AND ADI
NOTES FOR SOIL
REV. NOTE 10

PLAN GRADING Prepared POOL

21002 BLOCK Montgomery Township, Somerset County, New Je

Š

David J. Schn Professional E

LOI


y, 08; 908) DESIGN

ENGINEERING

Rocky Hill, New (908) 359-0989 NGINEERS AND O. BOX 792

SHEET NUMBER:

VOID

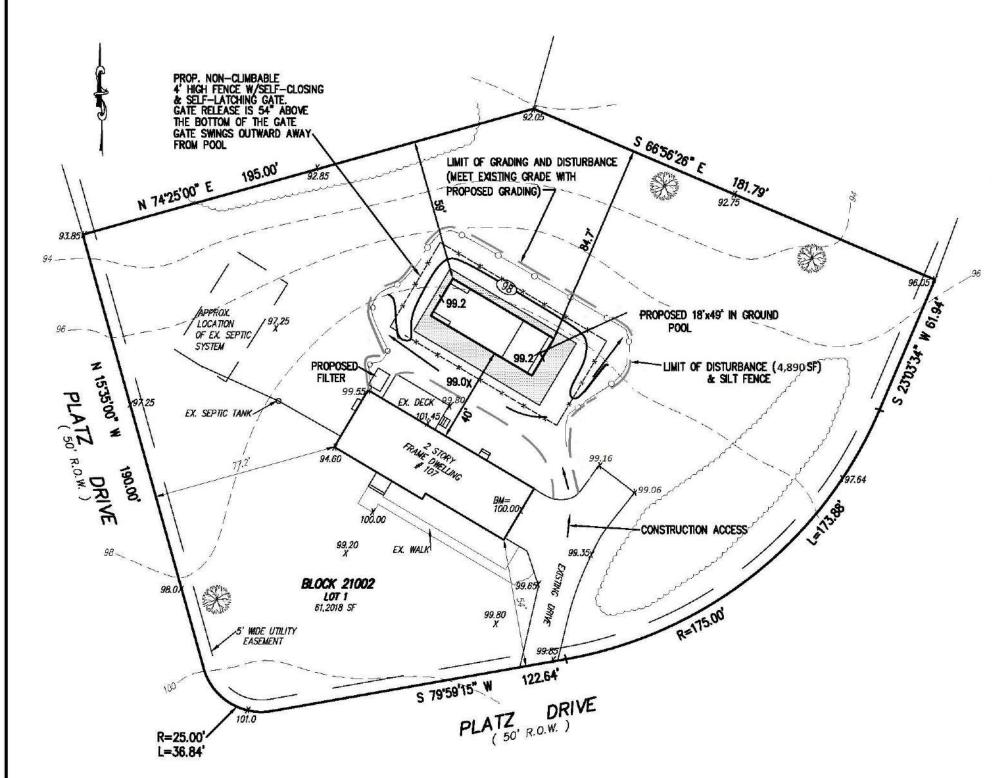

IMPERVIOUS COVERAGE SUMMARY

EX. DWELLING - 2,080 SF
EX. DRIVEWAY - 1,395 SF
EX. WALK & PORCH - 190 SF
EX. DECK - 250 SF
PROP. POOL & WALK - 1,830 SF

EX. TOTAL - 5,745 SF OR 9.38%

UTILITY NOTES:


- IT IS IMPERATIVE THAT UTILITY COMPANIES ARE NOTIFIED TO ANY EXCAVATION AND/OR CONSTRUCTION 1-800-272-1000.
- NO CERTIFICATION IS MADE BY D.S. ENGINEERING, P.C. AS TO THE ACTUAL POSITION OF ANY UNDERGROUND UTILITIES OR TO THE COMPLETENESS OF THE UTILITIES SHOWN.

MONTGOMERY TOWNSHIP NOTES:

- OTHER THAN THROUGH THE DRIVEWAY, CONSTRUCTION ACCESS OVER ROADSIDE CURB AND SIDEWALK IS NOT PERMITTED.
- ALL GROUND AND LOT COVERAGE REMOVAL REQUIRES INSPECTION. PROVIDE MINIMUM 48-HOUR NOTICE TO THE ENGINEERING DEPARTMENT.
- 3. FINAL AS-BUILT DRAWINGS BY PLS, STORMWATER MANAGEMENT SYSTEM CERTIFICATION BY EP, AND A GRADING CERTIFICATION BY EP ARE REQUIRED PRIOR TO THE ISSUANCE OF CERTIFICATES OF OCCUPANCY/APPROVAL.
- 4. USE OF ANY NEW FACILITY, STRUCTURE PRIOR TO OBTAINING A CERTIFICATE OF OCCUPANCY OR APPROVAL IS UNLAWFUL AND MOLATES TOWNSHIP CODE. FAILURE TO COMPLY IS SUBJECT TO ENFORCEMENT.
- 5. DAMAGE TO TOWNSHIP SIDEWALK RESULTING FROM THE PROJECT SHALL BE REPLACED BY THE OWNER, APPLICANT, OR RESPONSIBLE PARTY IN CHARGE OF WORK. A ROAD OPENING PERMIT APPLICATION MUST BE SUBMITTED TO THE MONTGOMERY TOWNSHIP ENGINEERING DEPARTMENT. FEES, INSURANCE DOCUMENTATION, AND OTHER REQUIREMENTS APPLY.

NOTES:

- OUTBOUND INFORMATION FOR BLOCK 12002 LOT 5 AS SHOWN ON A PLAN ENTITLED "SITE PLAN" PREPARED BY MAXIMILLIAN HAYDEN ARCHITECT, INC. DATED 10-7-16.
- 2.) TOPOGRAPHIC INFORMATION FOR BLOCK 12002 LOT 5 PREPARED ON FEBRUARY, 2021.
- 3.) PROPOSED POOL SIZE, LOCATION AND CONFIGURATION AS SUPPLIED BY THE HOMEOWNER.
- 4.) PROPOSED FENCE LOCATION AND TYPE AS PER HOMEOWNER.
- 5.) ASSUMED BENCH MARK OF 100.00 ON F.G.F.
- 6.) NO WETLANDS BUFFERS EXIST ON-SITE.
- 7.) ALL SOIL SHALL REMAIN ON-SITE.
- 8.) IF THE LIMIT OF DISTURBANCE IS EXCEEDED AN APPROVAL FROM THE S.U.S.C.O. SHALL BE OBTAINED AND A WORK ORDER ISSUED BY MONTGOMERY TOWNSHIP.
- 9.) APPROX. 45 CY OF SOIL WILL BE EXCAVATED FROM THE CONSTRUCTION OF THE POOL AND APPROX, 30 CY WILL BE GRADED WITHIN THE LIMIT OF DISTURBANCE. SHOULD THE LIMIT OF DISTURBANCE BE EXCEEDED (5000 SF) WITH THE REGRADING, AN APPLICATION TO THE S.U.S.C.D WILL BE REQUIRED. SEE NOTE ABOVE AND ON PLAN VIEW FOR LIMIT OF DISTURBANCE AREA.
- 10.) SHOULD SOIL EXCEEDING 20 CY NEED TO BE REMOVED FROM THE SITE, A SOIL HAULING PERMIT WILL BE REQUIRED AND A STOP WORK ORDER ISSUED.

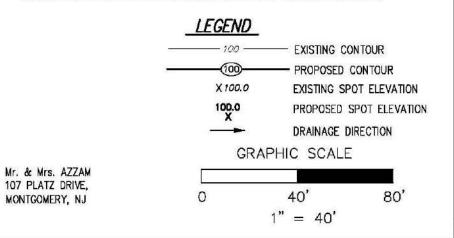

4/21/21	,0,	1	SGL		Sra	
DATE	.0 14 0	SVALE:	DESIGN BY:	DRAWN BY:	CHECKED BY:	750
DAIE	7-6-21	9-9-21	20 20	17-17-6		
AUTH.	ᅜ	ᅜ	ī	7		
REVISIONS	PER MONTGOMERY TWP.	PER MONTGOMERY TWP. ENG.	PER MONT. TWP	NOTES FOR SOIL		

POOL GRADING PLAN
Prepared For

BLOCK 21002 LOT 1 Montgomery Township, Somerset County, New Jerse

Š


David J. Schr Professional I

JESIGN PROFESSIONALS
Jersey, 08553
Fax (908) 359-4118

ENGINEERS AND DESIGN PF P.O. BOX 792 Rocky Hill, New Jersey, 0 (908) 359-0989 Fax (908)

ENGINEERING

SHEET NUMBER:

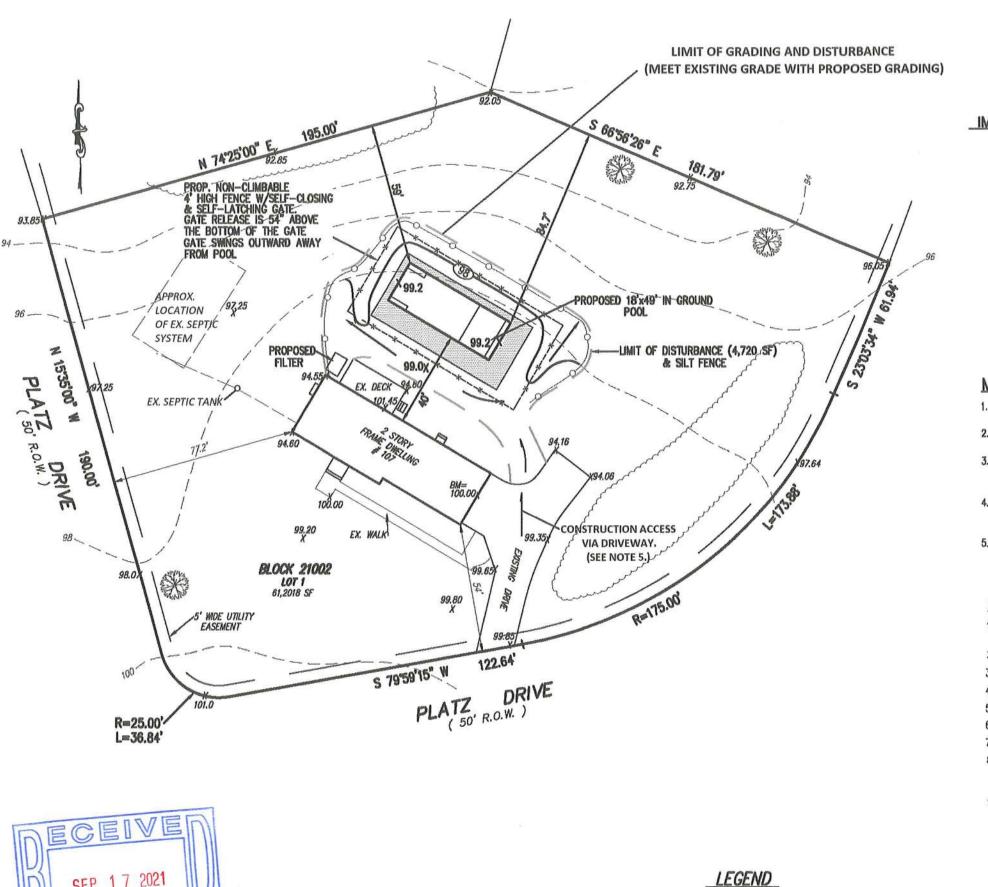



IMPERVIOUS COVERAGE SUMMARY

EX. DWELLING

- 2,080 SF

EX. DRIVEWAY

- 1,395 SF - 190 SF EX. WALK & PORCH

EX. DECK

- 250 SF

PROP, POOL & WALK - 1,830 SF

EX. TOTAL - 5,745 SF OR 9.38%

UTILITY NOTES:

- 1.) IT IS IMPERATIVE THAT UTILITY COMPANIES ARE NOTIFIED TO ANY EXCAVATION AND/OR CONSTRUCTION 1-800-272-1000.
- 2.) NO CERTIFICATION IS MADE BY D.S. ENGINEERING, P.C. AS TO THE ACTUAL POSITION OF ANY UNDERGROUND UTILITIES OR TO THE COMPLETENESS OF THE UTILITIES SHOWN.

MONTGOMERY TOWNSHIP NOTES:

- 1. OTHER THAN THROUGH THE DRIVEWAY, CONSTRUCTION ACCESS OVER ROADSIDE CURB AND SIDEWALK IS NOT PERMITTED.
- 2. ALL GROUND AND LOT COVERAGE REMOVAL REQUIRES INSPECTION. PROVIDE MINIMUM 48-HOUR NOTICE TO THE ENGINEERING DEPARTMENT.
- 3. FINAL AS-BUILT DRAWINGS BY PLS, STORMWATER MANAGEMENT SYSTEM CERTIFICATION BY EP, AND A GRADING CERTIFICATION BY EP ARE REQUIRED PRIOR TO THE ISSUANCE OF CERTIFICATES OF OCCUPANCY/APPROVAL.
- 4. USE OF ANY NEW FACILITY, STRUCTURE PRIOR TO OBTAINING A CERTIFICATE OF OCCUPANCY OR APPROVAL IS UNLAWFUL AND VIOLATES TOWNSHIP CODE. FAILURE TO COMPLY IS SUBJECT
- 5. DAMAGE TO TOWNSHIP SIDEWALK RESULTING FROM THE PROJECT SHALL BE REPLACED BY THE OWNER, APPLICANT, OR RESPONSIBLE PARTY IN CHARGE OF WORK. A ROAD OPENING PERMIT APPLICATION MUST BE SUBMITTED TO THE MONTGOMERY TOWNSHIP ENGINEERING DEPARTMENT. FEES, INSURANCE DOCUMENTATION, AND OTHER REQUIREMENTS APPLY.

NOTES:

Mr. & Mrs. AZZAM

107 PLATZ DRIVE,

MONTGOMERY, NJ

EXISTING CONTOUR

PROPOSED CONTOUR

DRAINAGE DIRECTION

EXISTING SPOT ELEVATION

PROPOSED SPOT ELEVATION

-(00)-

X 100.0

100.0 X

- 1.) OUTBOUND INFORMATION FOR BLOCK 12002 LOT 5 AS SHOWN ON A PLAN ENTITLED "SITE PLAN" PREPARED BY MAXIMILLIAN HAYDEN ARCHITECT, INC. DATED 10-7-16.
- 2.) TOPOGRAPHIC INFORMATION FOR BLOCK 12002 LOT 5 PREPARED ON FEBRUARY, 2021.
- 3.) PROPOSED POOL SIZE, LOCATION AND CONFIGURATION AS SUPPLIED BY THE HOMEOWNER.
- 4.) PROPOSED FENCE LOCATION AND TYPE AS PER HOMEOWNER.
- 5.) ASSUMED BENCH MARK OF 100.00 ON F.G.F.
- 6.) NO WETLANDS BUFFERS EXIST ON-SITE.
- 7.) ALL SOIL SHALL REMAIN ON-SITE.
- 8.) IF THE LIMIT OF DIST. IS EXCEEDED DURING CONSTRUCTION OF THE POOL, A STOP WORK ORDER BY MONT. TWP. SHALL BE ISSUED AND AN APPROVAL FROM THE S.U.S.C.D. SHALL BE OBTAINED PRIOR TO WORK CONTINUING.
- 9.) DURATION OF PROJECT IS APPROX. ONE WEEK

GRAPHIC SCALE 40'

1'' = 40'

PROFESSIONALS ENGINEERING DESIGN RS AND

SHEET NUMBER:

Jersey, 08553 Fax (908) 359-, New-0989 ENGINEERS P.O. BOX 7 Rocky Hill, (908) 359-09

BY:

DESIGN DRAWN

DATE

PER MONT.

PLAN

GRADING

POOL


21002

BLOCK

LOI

Prepared

wnship, New Jer

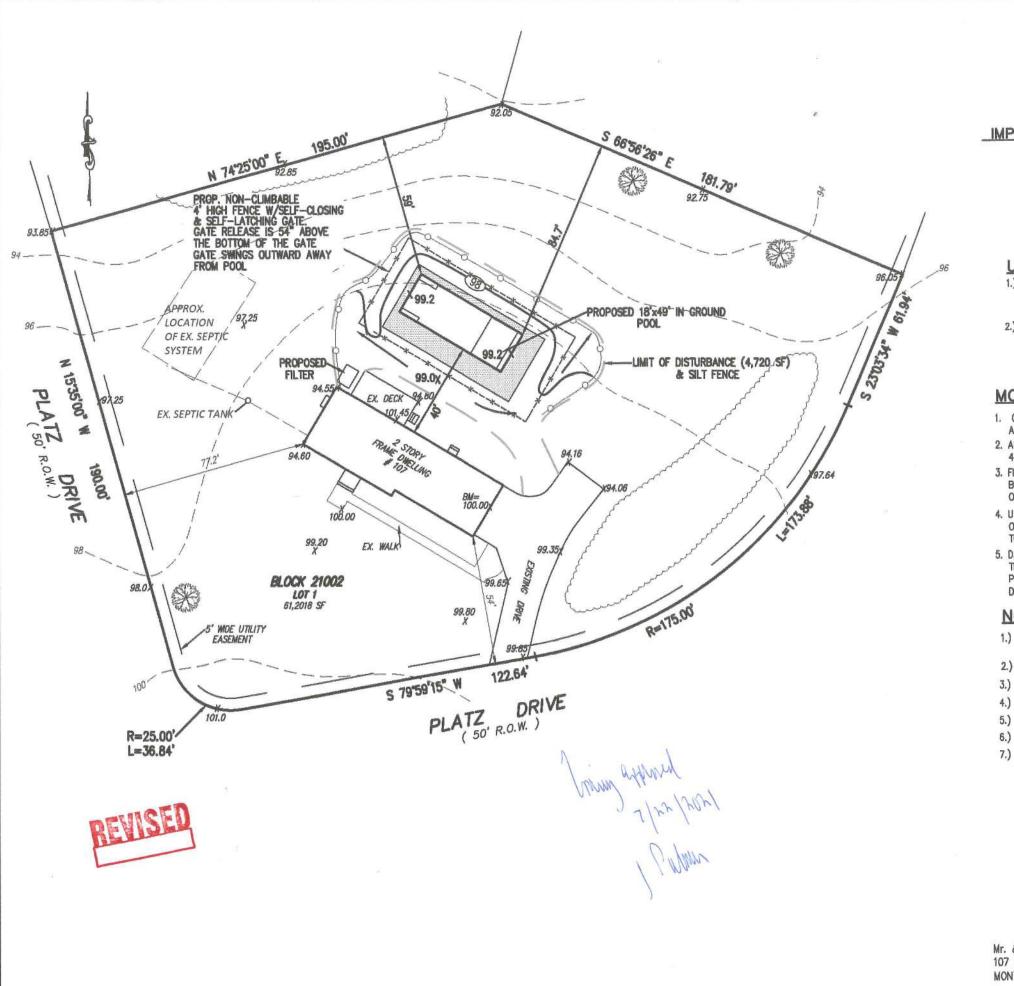

VOID

IMPERVIOUS COVERAGE SUMMARY

EX. DWELLING

- 2,080 SF - 1,395 SF

- 190 SF

EX. DRIVEWAY

EX. WALK & PORCH

EX. DECK - 250 SF

PROP. POOL & WALK - 1,830 SF

EX. TOTAL - 5,745 SF OR 9.38%

UTILITY NOTES:

- 1.) IT IS IMPERATIVE THAT UTILITY COMPANIES ARE NOTIFIED TO ANY EXCAVATION AND/OR CONSTRUCTION 1-800-272-1000.
- 2.) NO CERTIFICATION IS MADE BY D.S. ENGINEERING, P.C. AS TO THE ACTUAL POSITION OF ANY UNDERGROUND UTILITIES OR TO THE COMPLETENESS OF THE UTILITIES SHOWN.

MONTGOMERY TOWNSHIP NOTES:

- 1. OTHER THAN THROUGH THE DRIVEWAY, CONSTRUCTION ACCESS OVER ROADSIDE CURB AND SIDEWALK IS NOT PERMITTED.
- 2. ALL GROUND AND LOT COVERAGE REMOVAL REQUIRES INSPECTION. PROVIDE MINIMUM 48-HOUR NOTICE TO THE ENGINEERING DEPARTMENT.
- 3. FINAL AS-BUILT DRAWINGS BY PLS, STORMWATER MANAGEMENT SYSTEM CERTIFICATION BY EP, AND A GRADING CERTIFICATION BY EP ARE REQUIRED PRIOR TO THE ISSUANCE OF CERTIFICATES OF OCCUPANCY/APPROVAL.
- 4. USE OF ANY NEW FACILITY, STRUCTURE PRIOR TO OBTAINING A CERTIFICATE OF OCCUPANCY OR APPROVAL IS UNLAWFUL AND VIOLATES TOWNSHIP CODE. FAILURE TO COMPLY IS SUBJECT TO ENFORCEMENT.
- 5. DAMAGE TO TOWNSHIP SIDEWALK RESULTING FROM THE PROJECT SHALL BE REPLACED BY THE OWNER, APPLICANT, OR RESPONSIBLE PARTY IN CHARGE OF WORK. A ROAD OPENING PERMIT APPLICATION MUST BE SUBMITTED TO THE MONTGOMERY TOWNSHIP ENGINEERING DEPARTMENT. FEES, INSURANCE DOCUMENTATION, AND OTHER REQUIREMENTS APPLY.

NOTES:

- 1.) OUTBOUND INFORMATION FOR BLOCK 12002 LOT 5 AS SHOWN ON A PLAN ENTITLED "SITE PLAN" PREPARED BY MAXIMILLIAN HAYDEN ARCHITECT, INC. DATED 10-7-16.
- 2.) TOPOGRAPHIC INFORMATION FOR BLOCK 12002 LOT 5 PREPARED ON FEBRUARY, 2021.
- 3.) PROPOSED POOL SIZE, LOCATION AND CONFIGURATION AS SUPPLIED BY THE HOMEOWNER.
- 4.) PROPOSED FENCE LOCATION AND TYPE AS PER HOMEOWNER.
- 5.) ASSUMED BENCH MARK OF 100.00 ON F.G.F.
- 6.) NO WETLANDS BUFFERS EXIST ON-SITE.
- 7.) ALL SOIL SHALL REMAIN ON-SITE.

<u>LEGEND</u>	
100	- EXISTING CONTOUR
	- PROPOSED CONTOUR
X 100.0	EXISTING SPOT ELEVATION
100.0 X	PROPOSED SPOT ELEVATION
	DRAINAGE DIRECTION

Mr. & Mrs. AZZAM 107 PLATZ DRIVE, MONTGOMERY, NJ

	GRAPHIC SCALE	
		of light terms
0	40'	80'
	1" = 40'	

PLAN 21002 GRADING BLOCK & LOI

POOL

ENGINEERING

DESIGN

Township,

DJS BY:

CHECKED

DESIGN DRAWN

DATE

Montgomery T Somerset County, PROFESSIONALS

Jersey, 08553 Fax (908) 359-

z.

ENGINEERS AND DI P.O. BOX 792 Rocky Hill, New (908) 359-0989

SHEET NUMBER:

MONTGOMERY TOWNSHIP ZONING PERMIT APPLICATION	Township Use Only AMOUNT PAID \$ 50 CASH or CHECK # 13752 DATE 6 21 20 10 10 10 10 10 10 10 10 10 10 10 10 10
WORKSITE:	CABIT_OF CHECK #DATE
Block 21007 Lot 1	Zoning District
Street Address 107 Platz Dr	Skilmon, NJ, 08558
Property Owner Robin Azzam	
Mailing Address (if different)	CityState Zip Code
Daytime Phone 737 - 500 - 5740 Fax	Email Robin Azzar Elgraillo
APPLICANT (if not owner):	
Name National Pools Swner's Agen	Tenant Other
Address 2495 Brunswick Pikelity K	State NJ Zip Code 08648
Contact Person Brooke Katzyngo	
Daytime Phone 609-583-4542 Fax	69-587-4489 Email Permits @ and spas. ron
TYPE OF PERMIT REQUESTED (CHECK ALL New Construction Deck Addition/Alteration Pool/Spa/Hot Tub Accessory Building Lot Coverage (Shed, Garage, etc.) (Patio, Driveway, etc.) Description of Project/Use (please be specific):	Fence Sign Change Tenant/Use Other - (Commercial) Demolition - No Tenant Fit-Out Charge
Commercial Change of Tenant/Use: Previous Tenant/	antExisting Use
New Tenant	New Use Sq. Ft.
make this application. I understand that if any of t subject to penalties.	731/21 Township Use Only
	131/21 NO 1/m. 6/29/2021

ZONING PERMIT FEE SCHEDULE

Zoni	ing Permits	Fee
(a)	For review of new construction, building addition/alteration, accessory building, deck, pool/spa/hot tub, fence, tower, and sign permit applications	\$50.00
(b)	For review of application for the expansion of lot coverage	\$50.00
(c)	For review of Change of Use, Change of Tenant (Commercial), and Tenant Fit-Out	\$50.00
(For review of development in stream corridor involving, (1) A single family dwelling on a pre-existing vacant lot, including the filing of an elevation certificate (2) All other improvements	\$2,500.00 \$800.00
	improvements	\$800.00

MONTGOMERY TOWNSHIP

PRIOR APPROVALS FORM REQUIRED BEFORE REVIEW OF A CONSTRUCTION PERMIT BY THE CODE ENFORCEMENT DEPARTMENT

N.J.A.C.5:23-2.15(a)5

Prior to Code Enforcement reviewing any applications for a construction permit these prior approvals must be complete.

OWNE	RINFEE_ ARRAM	CONT	ROL# 51	896	
PROJE	CT/PROPERTY ADDRESS	WATZ DRI	16		
BLOCK	() X1007 LO	T			
1.	Planning Board/Zoning Board of Ad	justment – R	eview Date		
	Date of Board Approval	Case #			
	Copy of Resolution	Yes	No	N/A	
	Conditions Filed	Yes	No	N/A	
	Escrow/Inspection Fees Posted	Yes	No	N/A	
	Plat and/or deed filed	Yes	No	N/A	
Planning	Sign-off Signature of Approval		Date	<u>-</u>	
	way is current at time of issuance of permit was current at time of certificate of occur		No No	N/A N/A	
2.	Zoning – Review Date \\\\\\\\\\\\\\\\\\\\\\\\\\\\\\\	UN1			
	Approved for Zoning VES	1	NO		
	Approved for Zoning YES NEEDS COAH REVIEW YES	V		1	
	NEEDS COAITICE VIEW 125		110	\	
	1 C WWW		6/29/202	1	
Zoning S	Sign-off Signature of Approval		Date		
3.	Landmarks Commission – Review D	ateYes	No	- _{N/A}	
Landmai	ks Commission Sign-off Signature of Approval		Date		
(Over)				

4. Health Department – Review Date (0)	0/21	Bl Ty	k: ype:	ingrand pool	
The existing <u>septic system</u> will not be encroached adequately sized for the proposed work.	apon, all	HD setb	oacks will YE		
The existing well will not be encroached upon by t	he propo	sed worl	k. YES	s NO (NA public wa	
APPROVED 7/22/2\ DENIED	ate		PENDI		
Special Requirements:					
Health Department Sign-off Signature of Approval		7/2-	2/21		
5. Engineering – Review Date				Resolution / Permit No. / etc.	
Critical Areas / Flood Hazard Area	Yes	No	N/A	Resolution / 1 climit 1vo. / etc.	
Sewer Participation / Capacity Agreement	Yes	No	N/A		
Son Hauling / Disturbance Permit	Yes	No	N/A		
Drivqway Apron	Yes	No	N/A		
Road / Driveway Opening Permit	Yes	No	N/A		
and scape Approval	Yes	No	N/A		
Limit of Disturbance / SUSCD Approval	Yes	No	N/A		
Grading Approval	Yes	No	N/A		
Stormwater Management	Yes	No	N/A		
Easements Shown / Respected	Yes	No	N/A		
Conservation Easement / Deed Restriction	Yes	No	N/A	bk/pg:	
Resolution/Developer's Agreement Conditions Satisfied	Yes	No	N/A		
Other Outside Agency Approvals	Yes	No	N/A		
Information Sheet Completed	Yes	No	N/A		
Eng. Approval Required for CO/CA	Yes	No			
REVIEW LETTER(S) / CONDITIONS (see attached)		-	Dates		
			24.00		
Engineering Sign-off Signature of Approval			Date		
6. Assessor's Office – Review Date					
or randout a client from Date			1 1472		
1 0 0	(s	ee worksheet	:)		
Assessor's Signature of Approval Date					

EACH AND EVERY QUESTION (1-6) MUST HAVE AN APPROVED SIGN-OFF SIGNATURE